





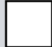

INDIANAPOLIS
INDIANA

LOWER LEVEL
AS BUILT

-  Available Space
-  Common Area
-  Leased Space

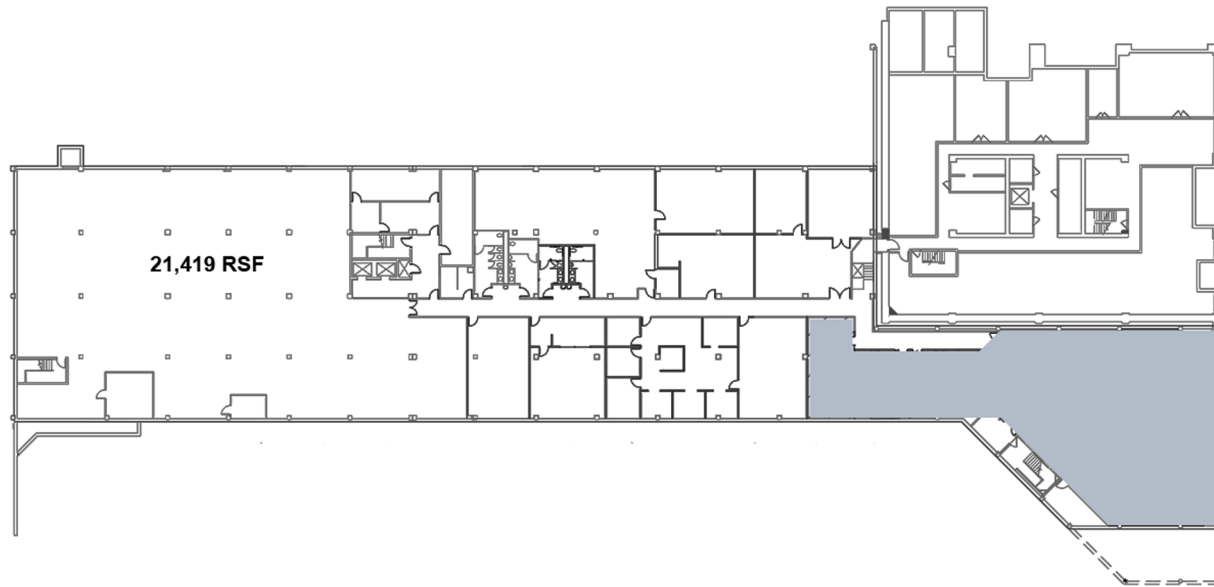

Owned and Managed By:

AMERIMAR WEST OHIO II MANAGEMENT COMPANY, INC. 317.684.3456