


OHIO STREET

CAPITOL AVENUE

ILLINOIS STREET

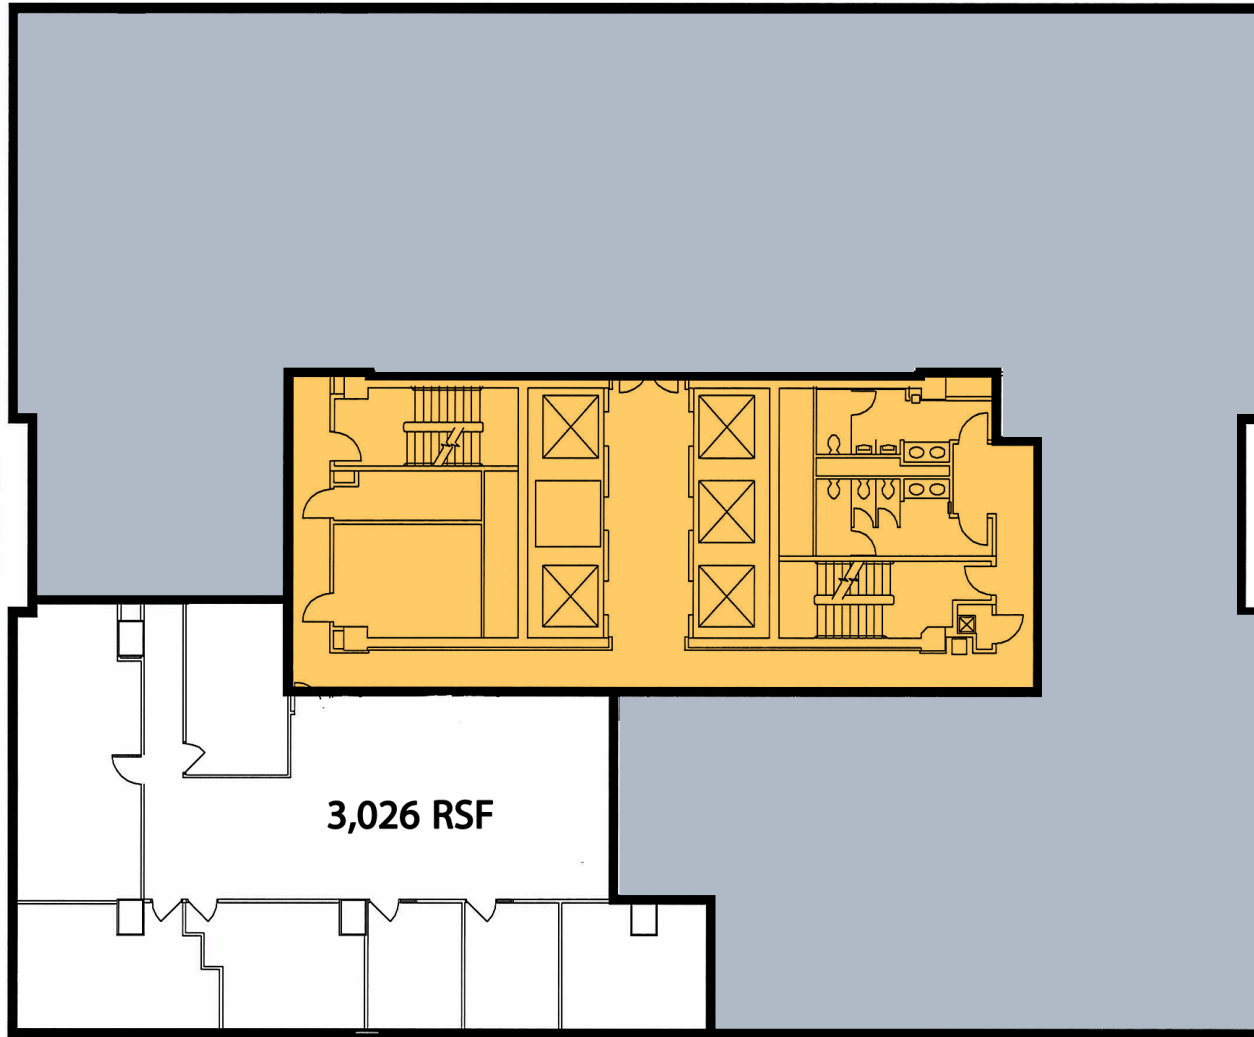

3,026 RSF

HILTON PLAZA VIEW

HILTON VIEW



INDIANAPOLIS
INDIANA

12TH FLOOR
AS BUILT

- Available Space
- Common Area
- Leased Space

Owned and Managed By:

AMERIMAR WEST OHIO II MANAGEMENT COMPANY, INC. 317.684.3456