


OHIO STREET

CAPITOL AVENUE



970 RSF

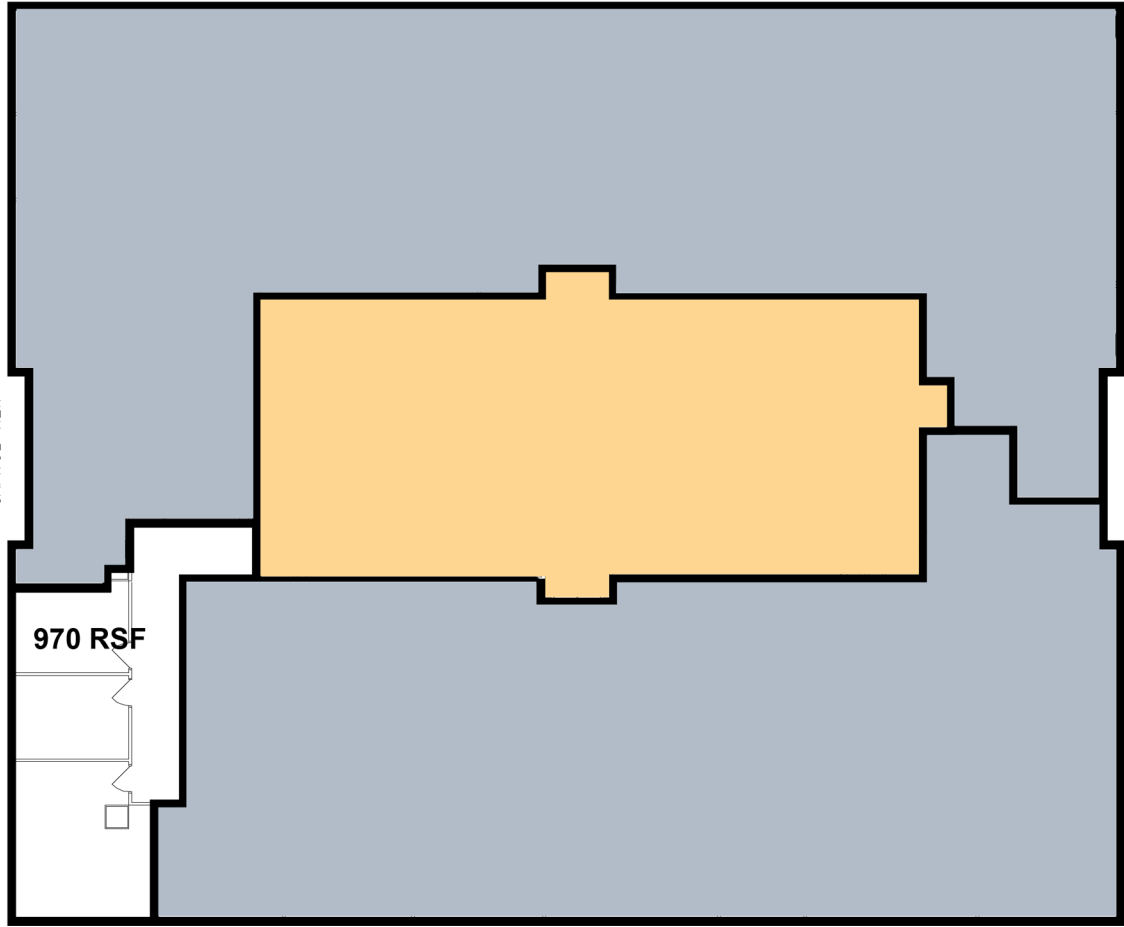


HILTON VIEW

ILLINOIS STREET



INDIANAPOLIS
INDIANA

14TH FLOOR
AS BUILT

-  Available Space
-  Common Area
-  Leased Space

Owned and Managed By:

AMERIMAR WEST OHIO II MANAGEMENT COMPANY, INC. 317.684.3456