


OHIO STREET

SUITE 400
5,118 RSF

CAPITOL AVENUE



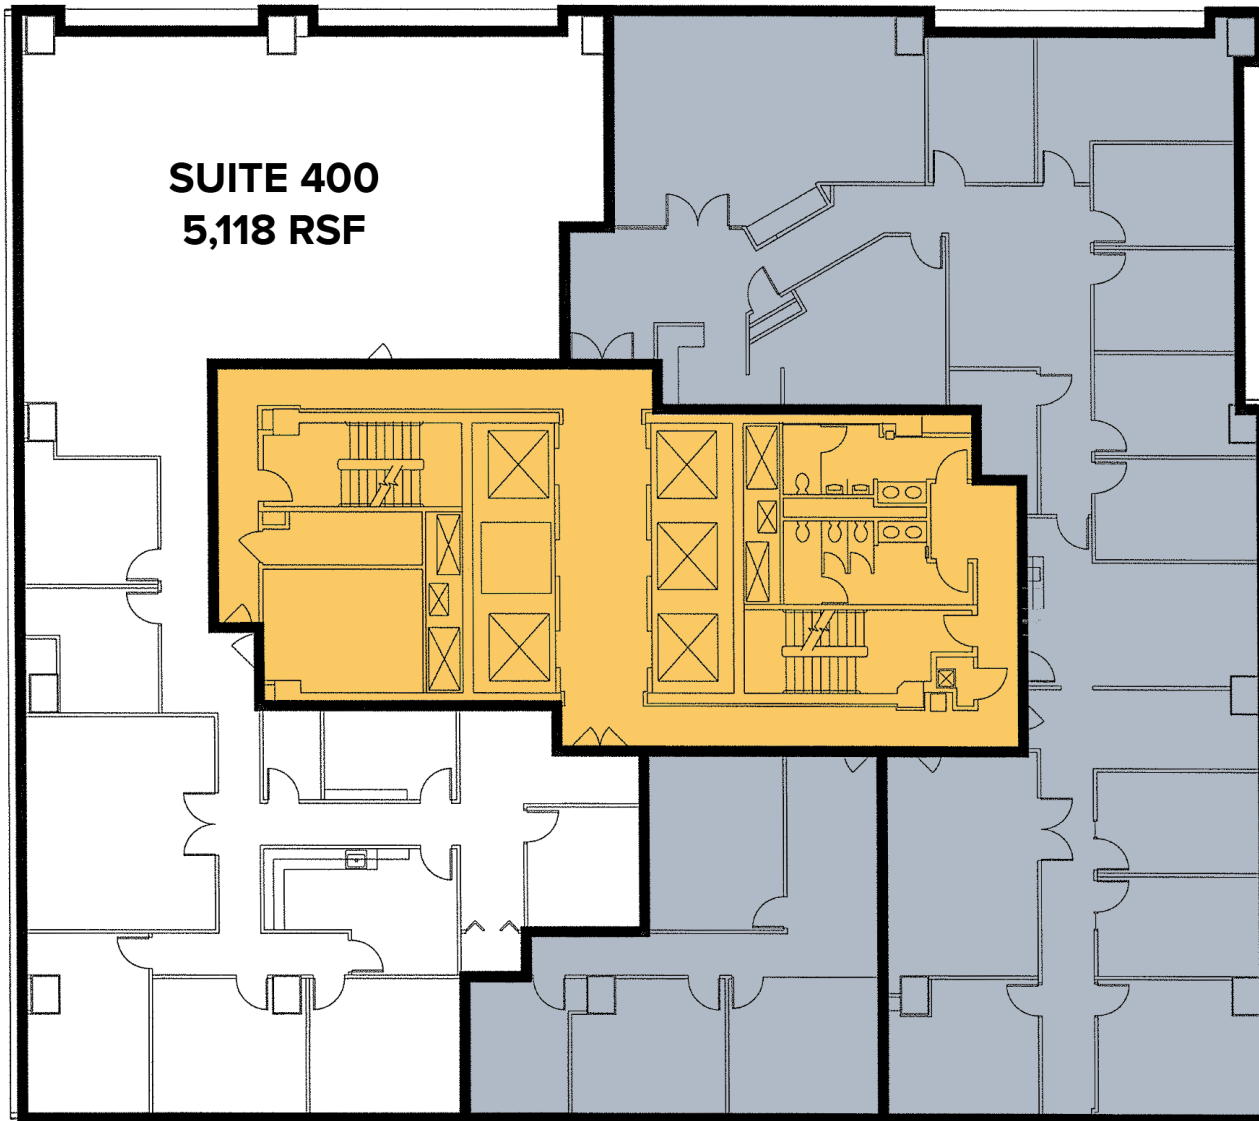


ILLINOIS STREET

HILTON VIEW



INDIANAPOLIS
INDIANA

4TH FLOOR
AS BUILT

-  Available Space
-  Common Area
-  Leased Space

Owned and Managed By:

AMERIMAR WEST OHIO II MANAGEMENT COMPANY, INC. 317.684.3456