


OHIO STREET

CAPITOL AVENUE

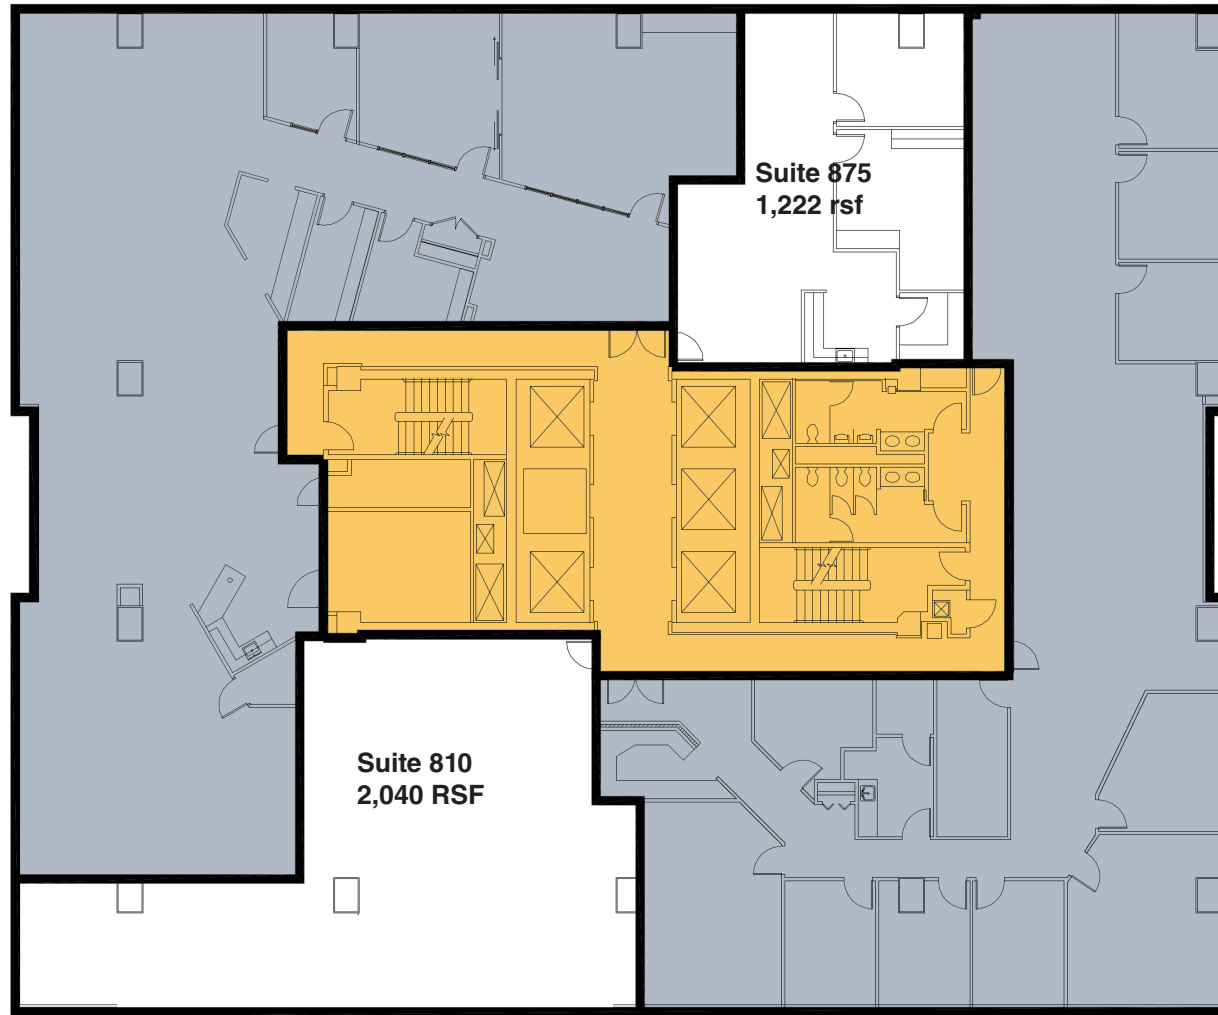

Suite 875  
1,222 rsf

Suite 810  
2,040 RSF




HILTON VIEW

ILLINOIS STREET



INDIANAPOLIS  
INDIANA

8TH FLOOR  
AS BUILT

-  Available Space
-  Common Area
-  Leased Space

Owned and Managed By:

AMERIMAR WEST OHIO II MANAGEMENT COMPANY, INC. 317.684.3456