


OHIO STREET

CAPITOL AVENUE

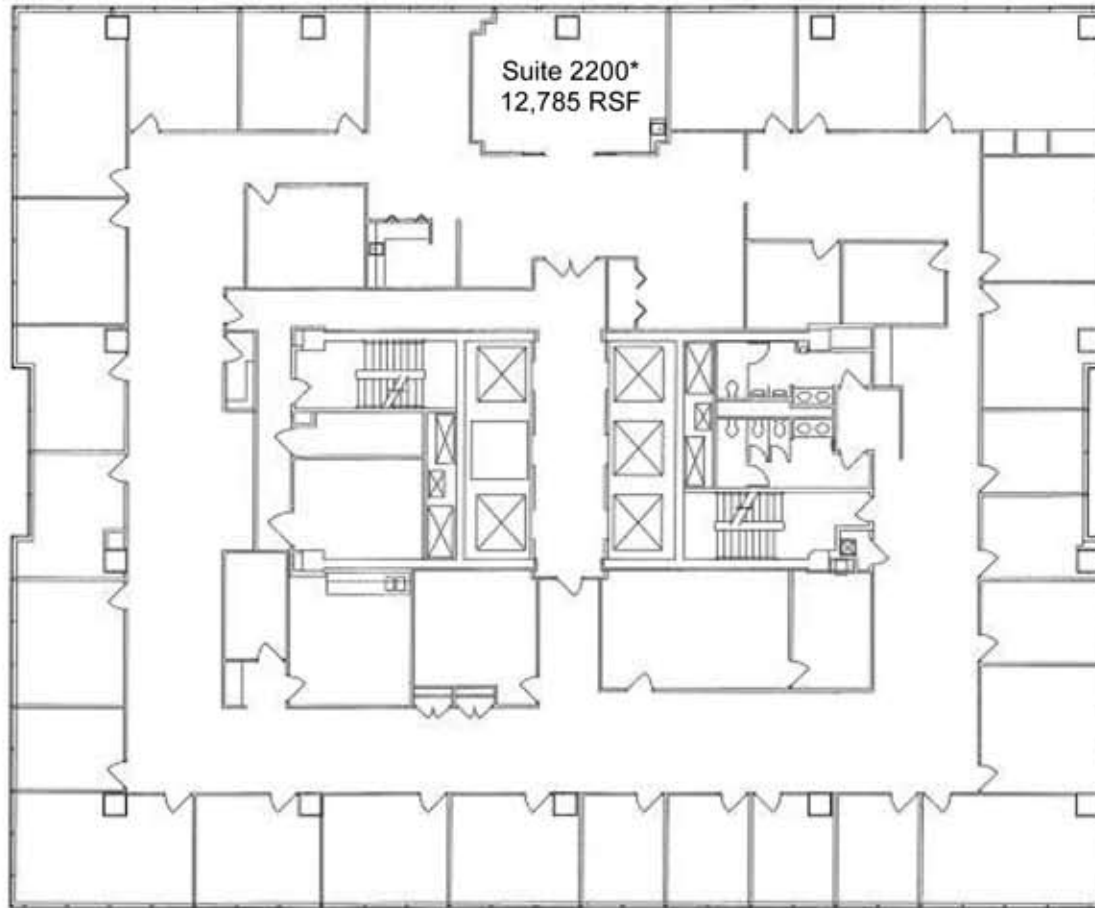

HILTON VIEW

ILLINOIS STREET



101  
WEST  
OHIO

INDIANAPOLIS  
INDIANA

22ND FLOOR  
ASBUILT

-  Available Space
-  Common Area
-  Leased Space

Owned and Managed By:

AMERIMAR WEST OHIO II MANAGEMENT COMPANY, INC. 317.684.3456